

ITEM 2  
BUILD  
TOWER +  
FIT NEW  
HEADER  
TANKS +  
SERVICES

ITEMS  
CHECK WCs HAVE  
WATER  
IF NOT  
CONNECT  
TO MCW

ITEM 1  
CUT  
SERVICE  
PIPES  
HERE  
ITEM 4 CAP OFF  
AFTER  
DEMOLITION


ITEM 3  
BUILD PLATFORM + FIT NEW  
HEADERTANKS + SERVICES

MECHANICAL RECOVERY PLAN

**York High School  
Lowfields Site  
Mechanical Recovery Plan**

1. Mechanical pipework services to be cut to the fire side of the steel beam retained at the caretakers office to enable demolition (marked in red on drawing cut services here)
2. Build structural scaffold tower from the hall stage access door to 1m below the top of the chimney. This tower is to carry new Hotwater (1 tonne – 1000litre ) and Heating (500 kg – 500litre ) header tanks. Provide Tanks and bring services from existing plantroom 50 MDPE to 40 ball valve in HWS header tank, 32 ball valve in Heating Header tank. Outlets from tanks to connect to existing services in plantroom. Insulate tanks and pipes exposed to outside air.
3. Build a platform to carry header tanks straddling the walls above boys girls change (subject to structural engineers OK) for new Hotwater (500 kg – 500litre ) and Heating (200 kg – 250litre ) header tanks. Provide Tanks and bring services from existing service 32 MDPE to 25 ball valve in HWS header tank, 22 ball valve in Heating Header tank. Outlets from tanks to connect to existing services in plantroom. Insulate tanks and pipes exposed to outside air.
4. After demolition cap all cut services at red line on drawing, pressure test and bring back into use sterilize all HWS & CWS services.
5. Check all WCs have water, if not connect to MCW.

This will bring back into use the area marked blue around the sports hall.  
All areas above the red line.

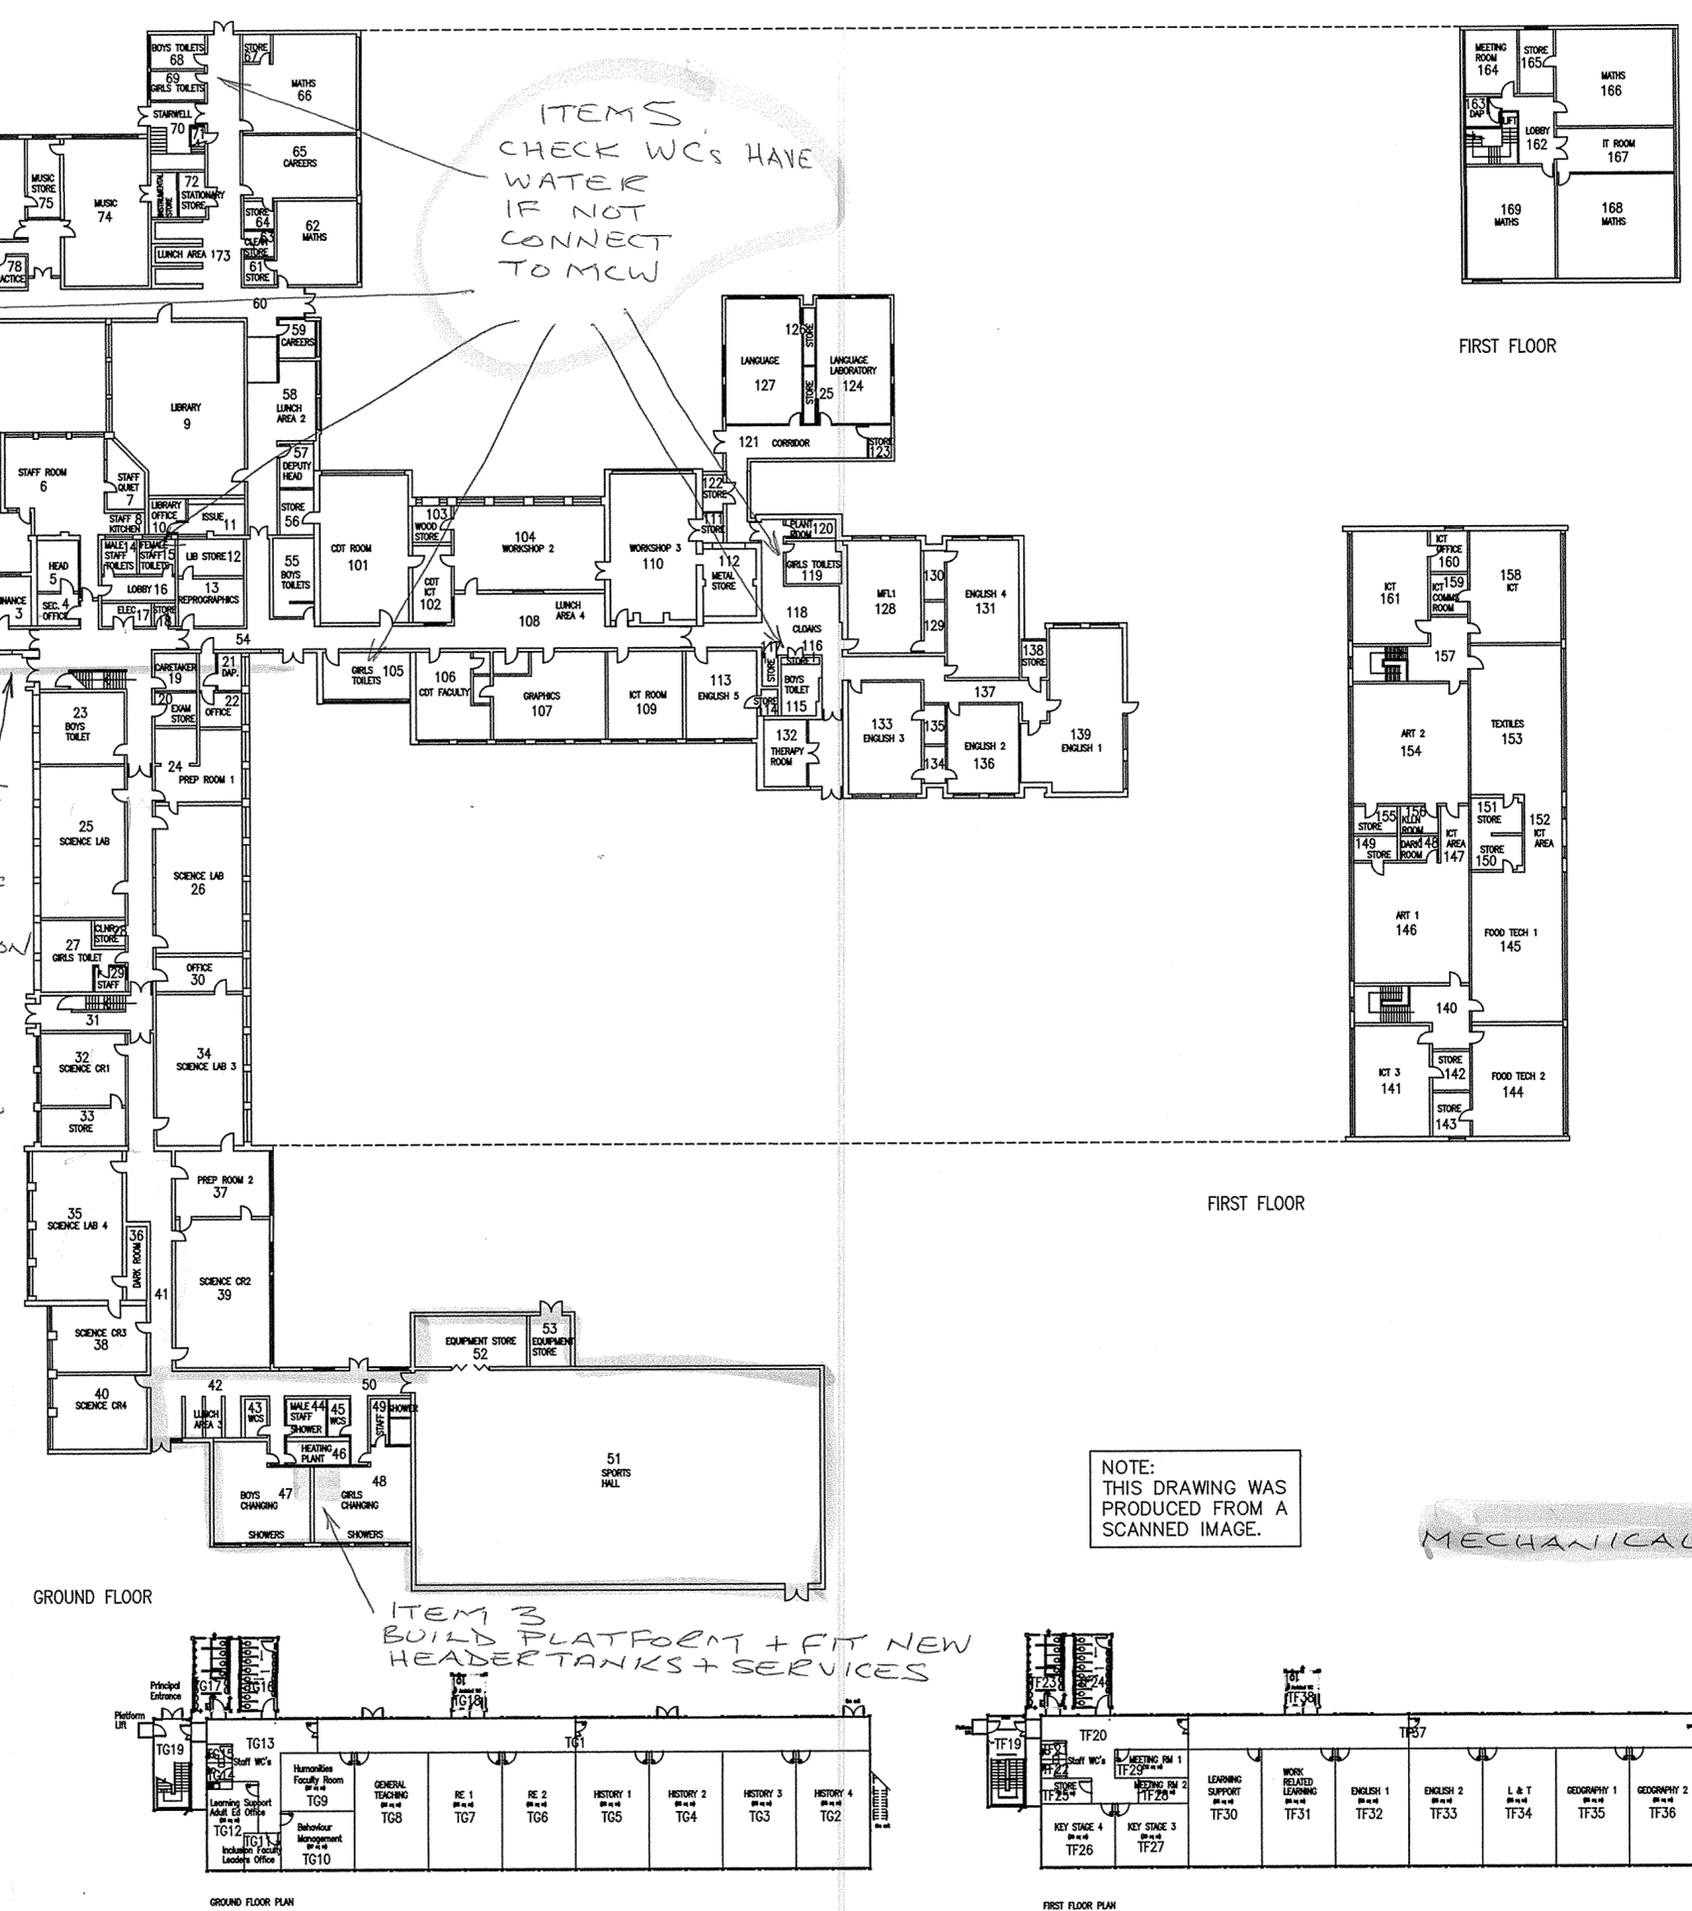

NOTE:  
THIS DRAWING WAS  
PRODUCED FROM A  
SCANNED IMAGE.

**CITY OF YORK COUNCIL**  
Resources  
Property Services

City Finance Centre, PO Box 31, Library Square, York YO1 7DU  
YORK HIGH SCHOOL  
DIJON AVENUE

FLOOR PLANS

DRAWN BY AT  
GROUP  
TEL No 01904 553229  
MOB No  
FAX No 01904 553424  
EMAIL  
CAD 2007

SCALE @AO 1/200  
DATE APRIL 07

DWG No 0429/07A  
DO NOT SCALE FROM THIS DRAWING